HOLLOWS AS-BUILTS

LOCATED IN SECTIONS 8 & 17, TOWNSHIP 14S, RANGE 5E, SLB&M
FAIRVIEW, UTAH

Division of Public Utilities
Docket No. 25-2280-03
DPU Exhibit 1.11

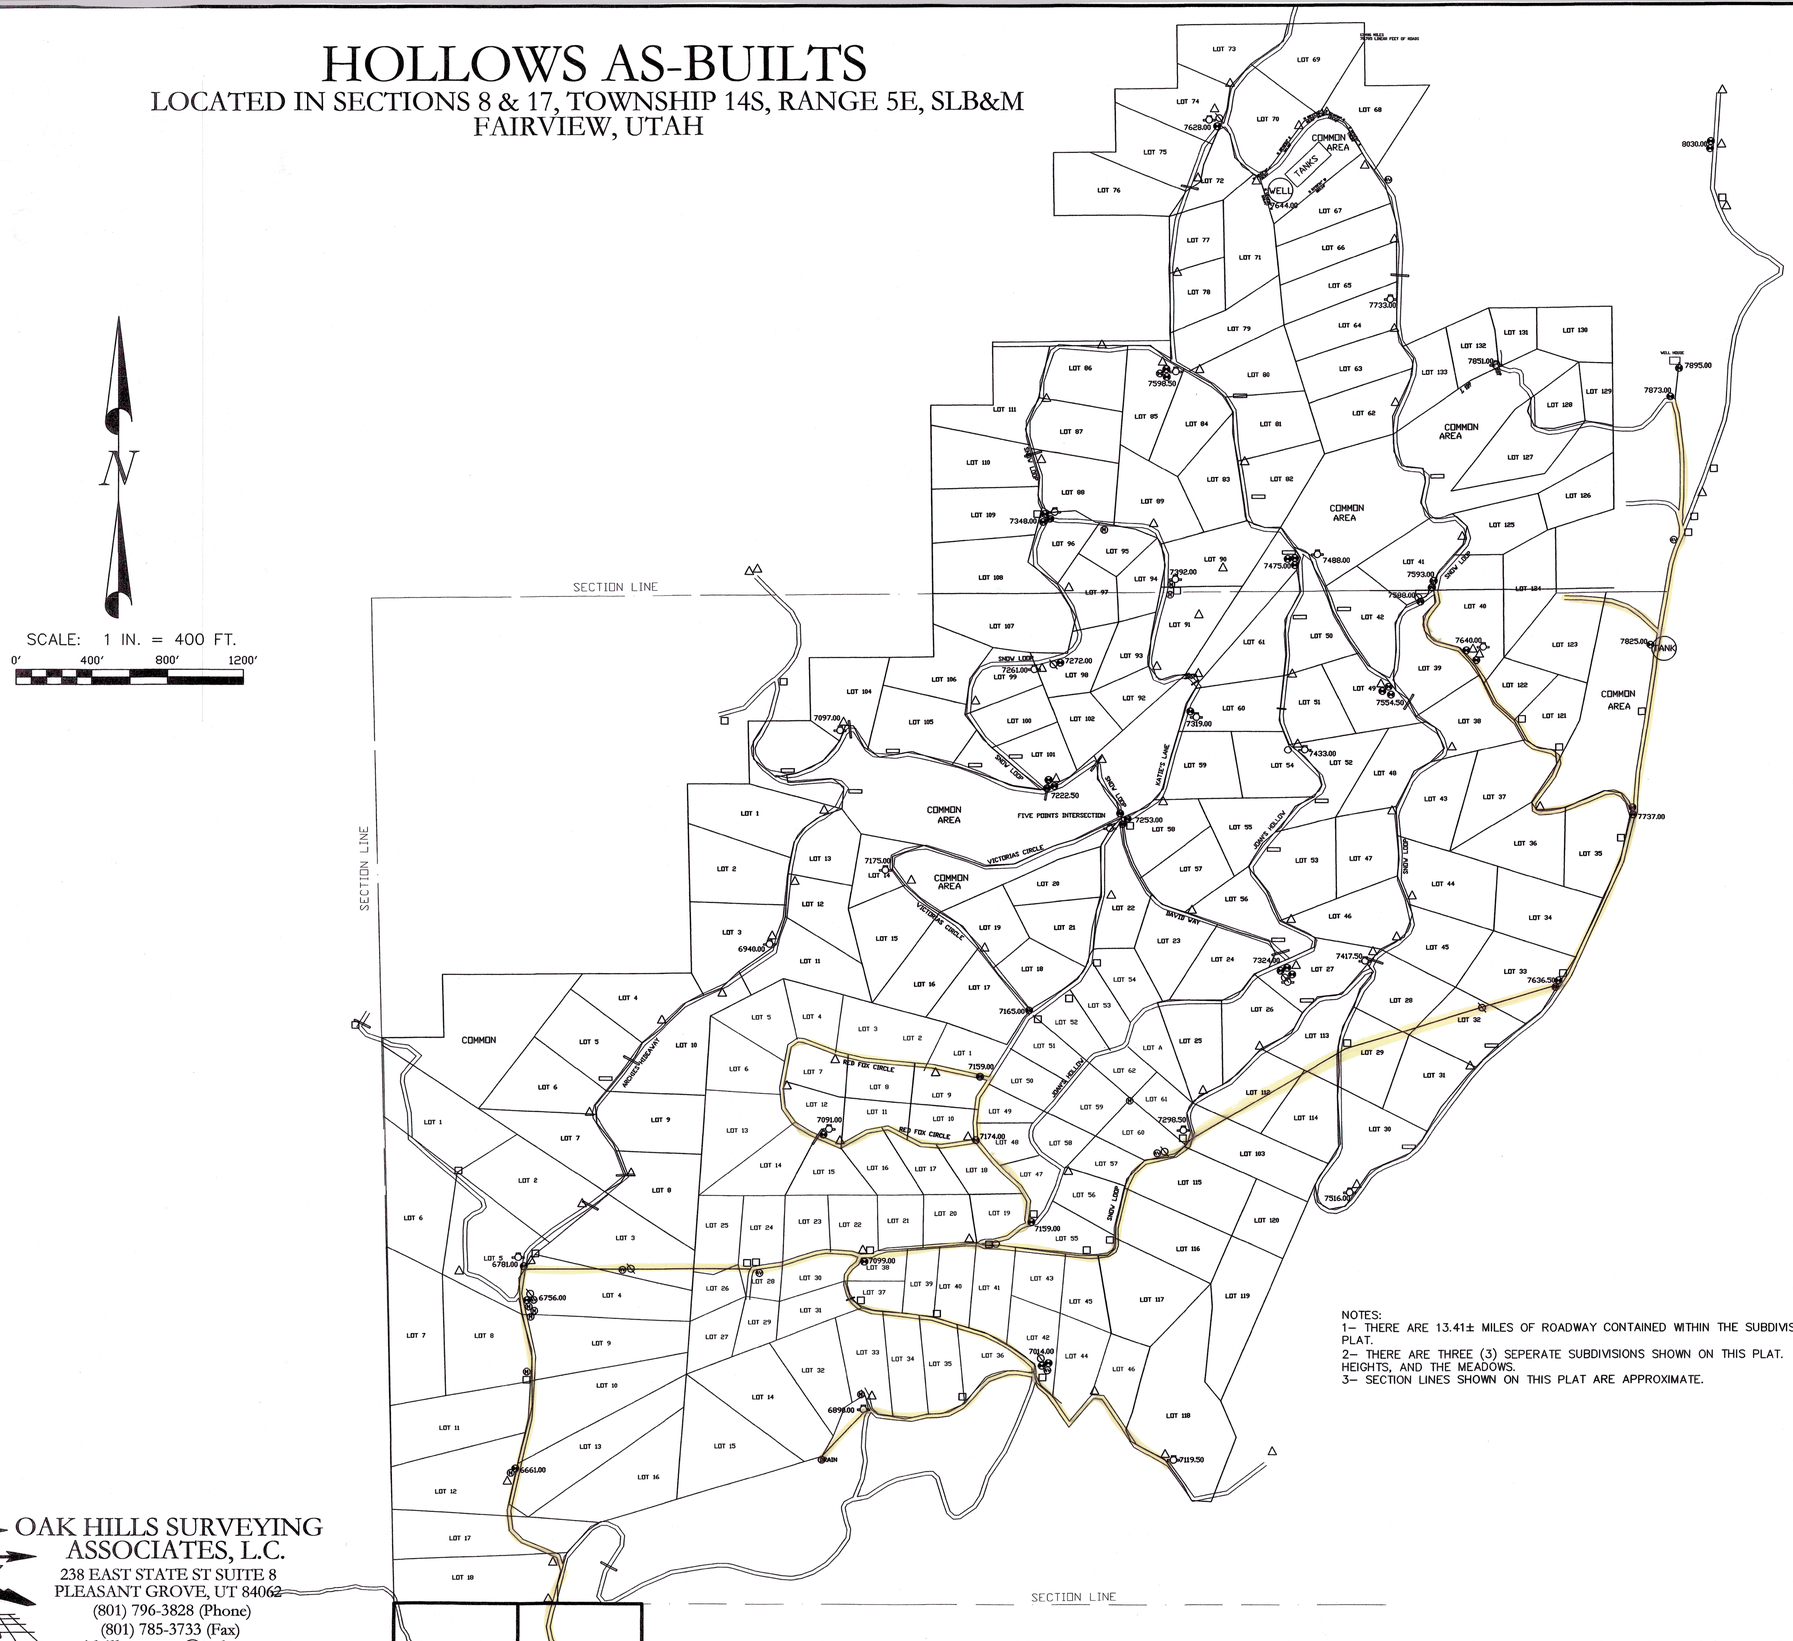

NOTES:
1– THERE ARE 13.41± MILES OF ROADWAY CONTAINED WITHIN THE SUBDIVISIONS OF THIS AS–BUILT PLAT.
2– THERE ARE THREE (3) SEPERATE SUBDIVISIONS SHOWN ON THIS PLAT. THE HOLLOWS, SKYLINE HEIGHTS, AND THE MEADOWS.
3– SECTION LINES SHOWN ON THIS PLAT ARE APPROXIMATE.

LEGEND

- SECTIONALIZER
- 3 PHASE
- TRANSFORMER
- FIRE HYDRANT
- PRV VALVE
- WATER VALVE
- (M) WATER METER
- CULVERT
- (AV) AIR VAC
- PVC PIPE 1999

OAK HILLS SURVEYING ASSOCIATES, L.C.
238 EAST STATE ST SUITE 8
PLEASANT GROVE, UT 84062
(801) 796-3828 (Phone)
(801) 785-3733 (Fax)
oakhillssurvey@aol.com

SURVEYOR'S SEAL

HOLLOWS AS–BUILTS

REQUESTED BY:
JOHN MAUGHAN

DRAWN KSB	DATE 10/15/07	SECTIONS 8 & 17 T.14S., R.5E., SLB&M
APPROVED FDE	DATE	FAIRVIEW, UTAH
SCALE 1" =400'	SHEET 1	PROJECT NO. 07–324